
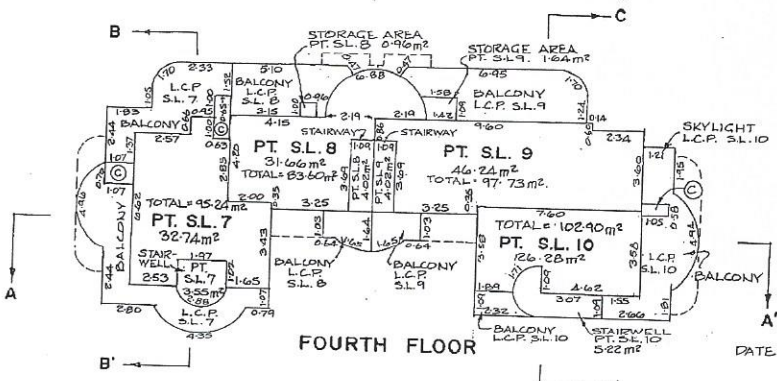
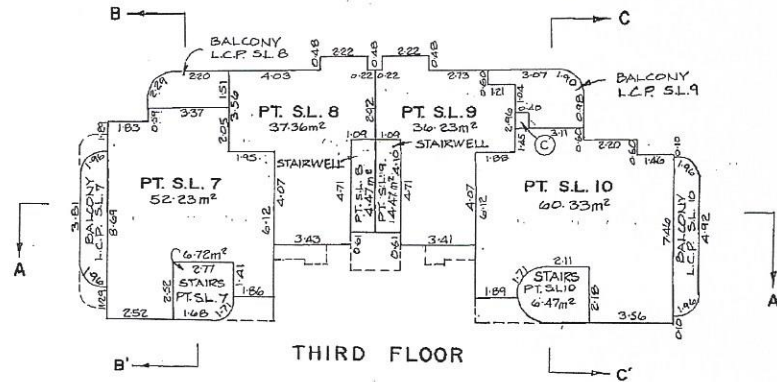
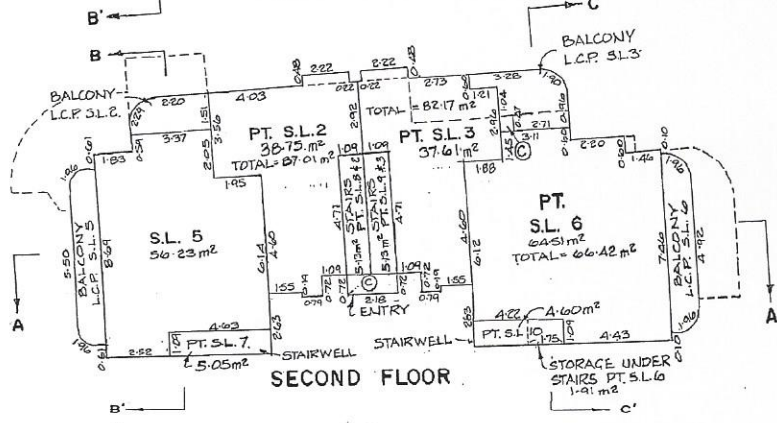


FLOOR PLANS

SCALE 1:200

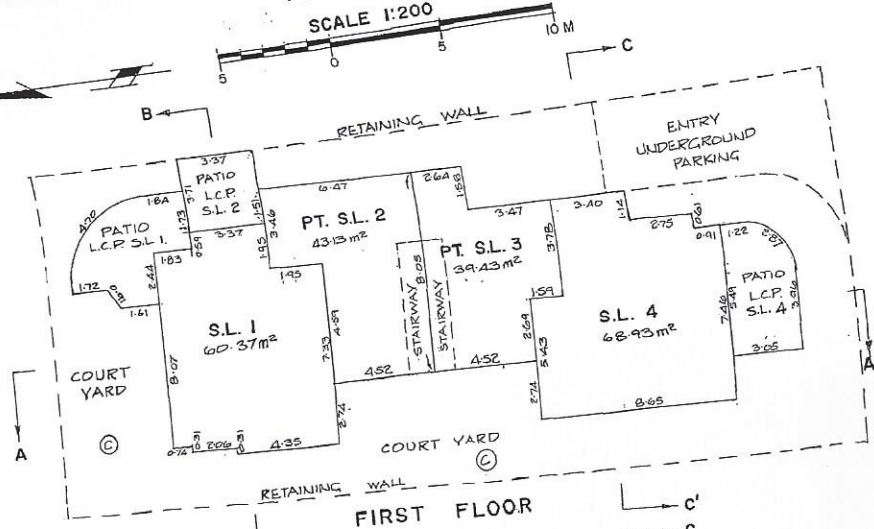

83.6 x
10.764
= 899.8
58.8

DATED THIS 11th DAY OF MAY, 1988

W.M. Griffith
B.C.L.S.



RE/MAX

SELECT PROPERTIES




LAURIE MACDONELL
604-313-2025

#8-1966 YORK AVE.,
VANCOUVER, B.C.

TOP FLOOR	412 SQ. FT.
MAIN FLOOR	433 SQ. FT.
LOWER ENTRY	17 SQ. FT.
*TOTAL	862 SQ. FT.

ROOF DECK	208 SQ. FT.
BALCONY 1	95 SQ. FT.
BALCONY 2	34 SQ. FT.
BALCONY 3	50 SQ. FT.

*Area calculations taken to centre of perimeter walls.

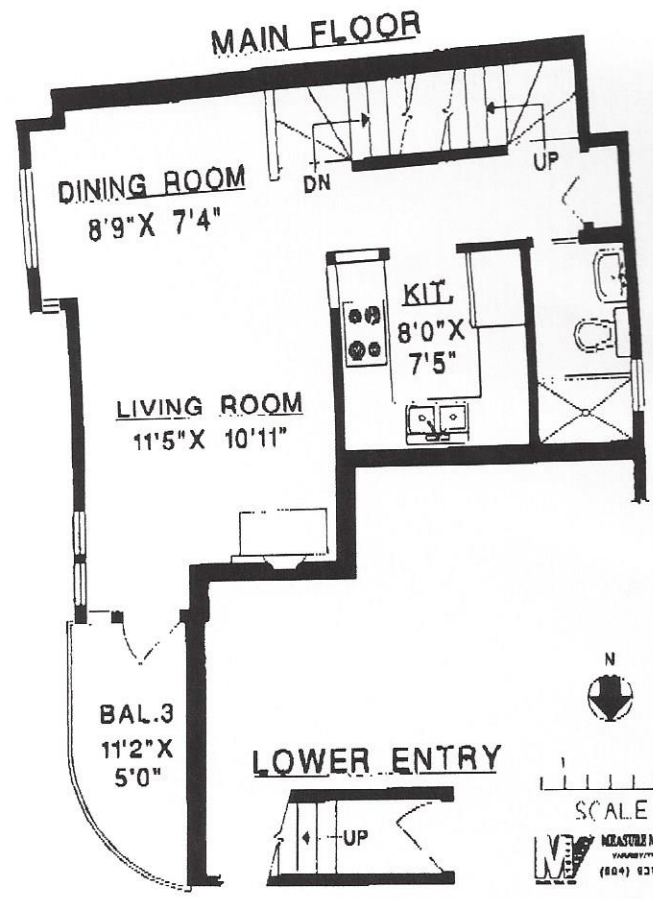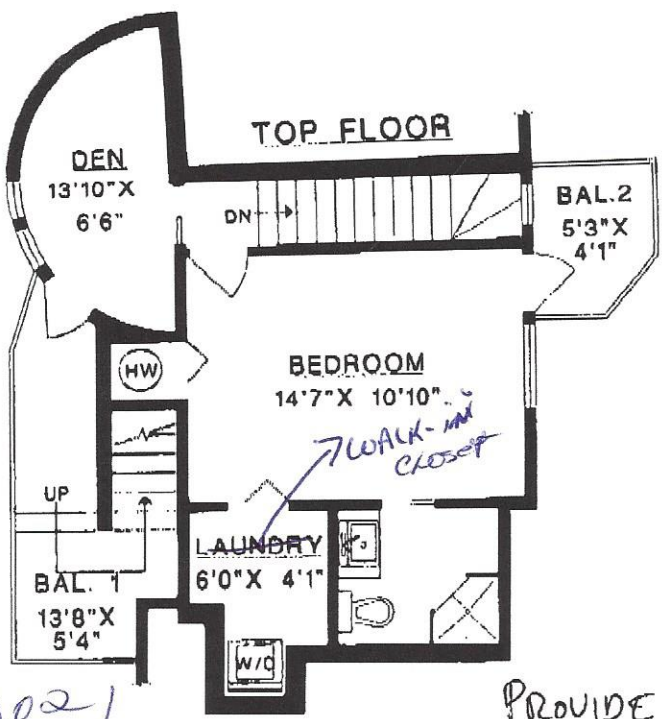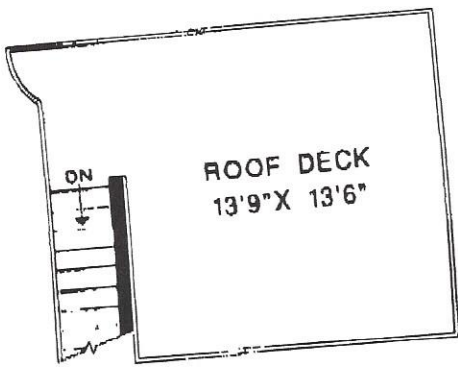

4.02
37.6 m² main
4.47 m² - stairs
31.66 m²
Please provide
fax 'OK' to
604-931-4515
THANKS

PROVIDE DATA
IF YOU WISH
TO USE
STRATA AREA

VR 2175
LMS: # 2175 SL: # 8
Survey Date: JUNE 22 1988.
Size: registered m2 or sq. ft.
Main: _____ Upper: _____
Lower: _____ Total: _____

Total: 83.6 m² x 10.76V
= 900 \$

OK with charges